APPENDIX "B"
to
REPORT PLAN2018-050
D01-2018-002, D06-2018-012
FILE NO. D05-2018-002 + D05-18-032

AREA TABLE	17324-1sk November 20, 2017	
Residential Single	Lots 1-146	8.885
Residential Reserve	Block 147	0.034
SWM Pond	Block 148	0.712
Walkway	Blocks 149, 150	0.060
Road Widening	Block 151	0.144
20m R.O.W		2.793
TOTAL		12.628 ha±

UNITS		
18.0m Single Detached	A	14
15.0m Single Detached	B	64
12.0m Single Detached	C	68
TOTAL		146 u

Red Lines and Text reflects revised plan from Surveyor.

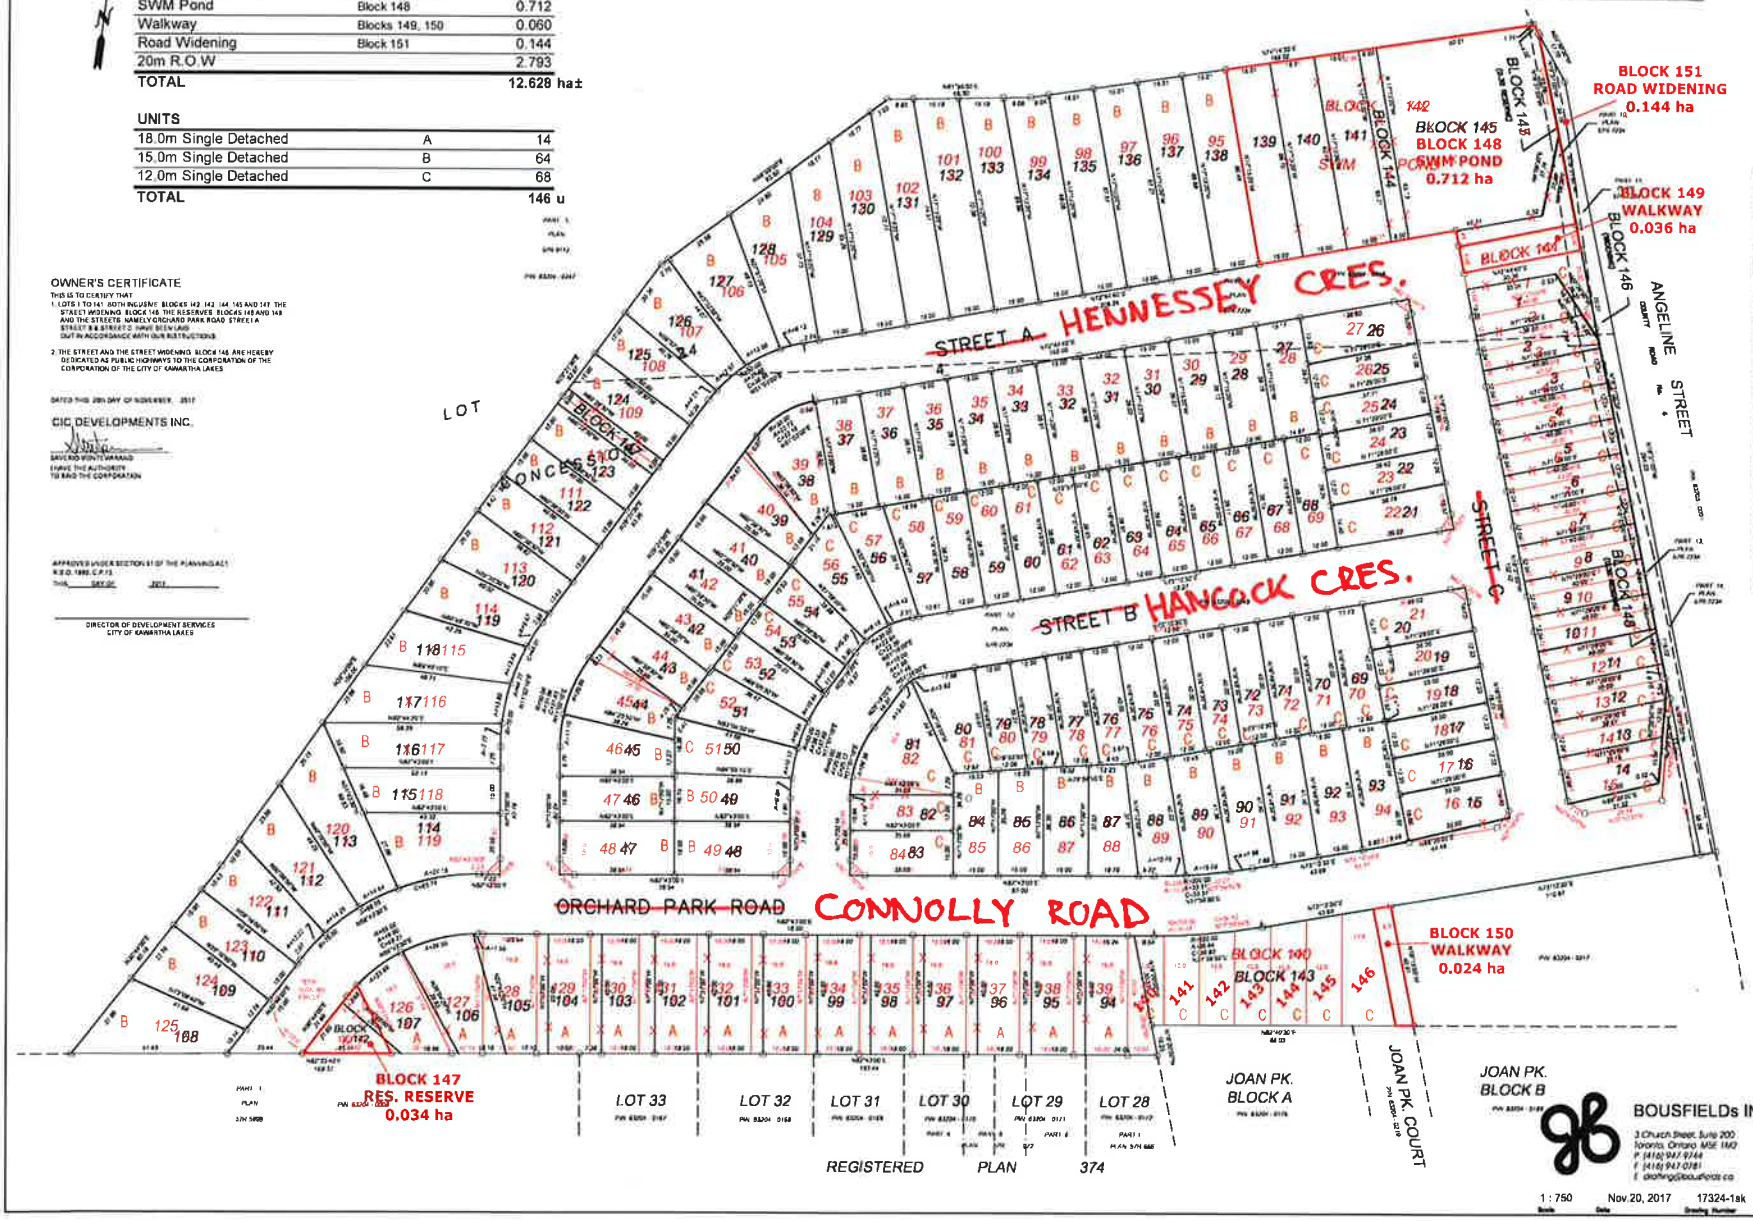

OWNER'S CERTIFICATE

THIS IS TO CERTIFY THAT
1. LOTS 1 TO 141 BOTH INCLUSIVE BLOCKS 142, 143, 144, 145 AND 147 THE STREET WIDENING BLOCK 146 THE RESERVES BLOCKS 148 AND 149 AND THE STREETS NAMELY ORCHARD PARK ROAD STREET A STREET B & STREET C HAVE BEEN LAID OUT IN ACCORDANCE WITH OUR INSTRUCTIONS.
2. THE STREET AND THE STREET WIDENING BLOCK 146 ARE HEREBY DEDICATED AS PUBLIC HIGHWAYS TO THE CORPORATION OF THE CORPORATION OF THE CITY OF KAWARTHA LAKES

DATED THIS 28th DAY OF NOVEMBER, 2017

CIC DEVELOPMENTS INC.

I HAVE THE AUTHORITY TO BIND THE CORPORATION

APPROVED UNDER SECTION 51 OF THE PLANNING ACT R.S.O. 1990, C.P.13

THIS DAY OF 2017

DIRECTOR OF DEVELOPMENT SERVICES
CITY OF KAWARTHA LAKES




















BOUSFIELDs INC.
3 Church Street, Suite 200
Toronto, Ontario M5E 1M2
P (416) 947 9744
F (416) 947 0781
E drafting@bousfields.ca

1 : 750 Nov.20, 2017 17324-1sk
Scale Date Drawing Number

